

NOTICE OF A PROPOSED CHANGE TO AN APPROVED RENEWABLE ENERGY PROJECT

Project Name: Suncor Energy Adelaide Wind Power Project (the "Project")

OPA Reference Number: FIT-F3ECN6R

Project Location: Municipality of Adelaide Metcalfe, County of Middlesex

Dated at: Municipality of Adelaide Metcalfe this the 21st of September, 2016.

Suncor Energy Products Inc. (Suncor) was issued a Renewable Energy Approval on December 11, 2013 in respect of the Suncor Energy Adelaide Wind Power Project. Information with respect to the decision on this project can be viewed on the Environmental Registry by searching EBR # 011-8848.

Suncor is proposing to make a change to the project and the project itself is subject to the provisions of *the Environmental Protection Act of Ontario* (Act) Part V.0.1 and Ontario Regulation 359/09 (Regulation). This notice is being distributed to make the public aware of a **proposed change to the project**.

Project Description and Proposed Change:

Pursuant to the Act and Regulation, the project in respect of which the REA was issued, is a Class 4 wind facility. An application has been made to the Ministry of the Environment and Climate Change to **change the project** and alter the terms and conditions of the existing REA. During a review of the Project's final as-built design, it was found that an access road and collector cable leading to Turbine WTG 22 was installed with a slight deviation from the approved location. The as-built access road and cable leading to WTG 22 was constructed on top of an existing farm lane through an unassessed area of land approximately 0.35 acres in size. Suncor is seeking to amend the Project's REA to reflect the as-built location of the access road and collector cable.

If approved with this change, the total maximum name plate capacity will remain unchanged at 40 MW. The project location, taking the proposed changes into account, is described in the map.

Documents for Public

Inspection:

Suncor has been required to update the supporting documents that are required to form part of the application or which must otherwise be submitted to the Ministry of the Environment and Climate Change available to the public. Written copies of the supporting documents are available for public inspection on the project website (www.suncor.com/adelaidewind).

Project Contacts and Information:

To learn more about the project or to communicate concerns please contact:

Anne Harding

Sr. Advisor, Stakeholder and Aboriginal Relations


Suncor Energy Products Inc.

150 6th Ave SW

Calgary, AB T2P 3E3

Telephone: 1-866-344-0178

Project Email: Adelaide@suncor.com

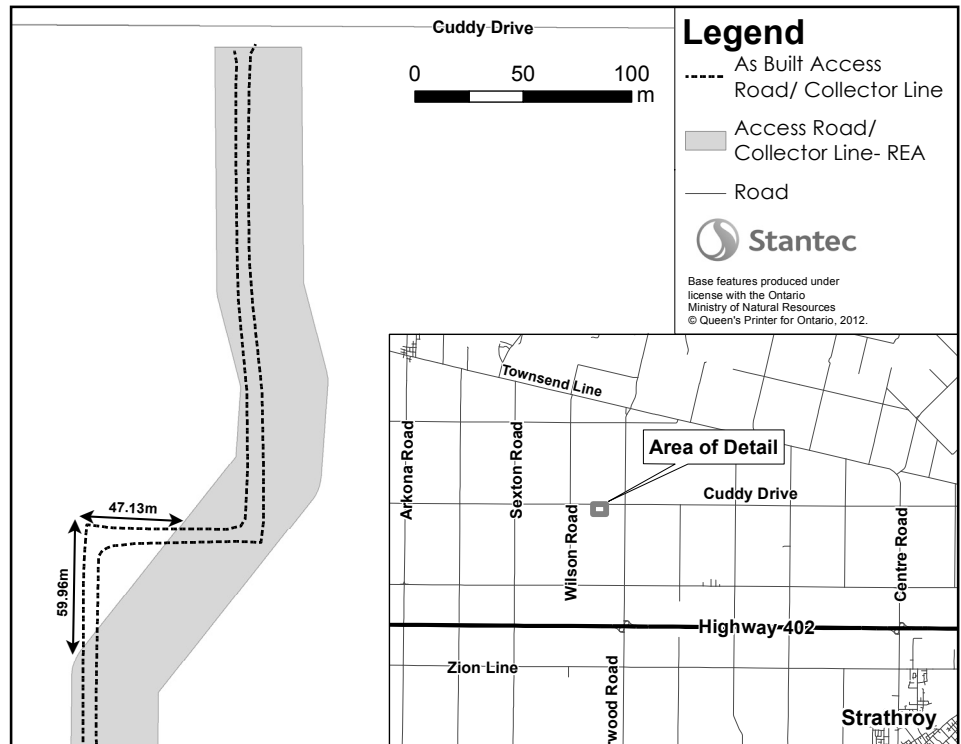

SUNCOR